


KEY

	denotes 4 1/2" structural brickwork
	denotes 4 1/2" external leaf brickwork
	denotes 4 1/2" (stretcher bond) partition brickwork with top course left off until slab is cast and formwork struck
	denotes 140mm dense blockwork
	denotes making good brickwork (toothed in) at alterations to existing brick walls

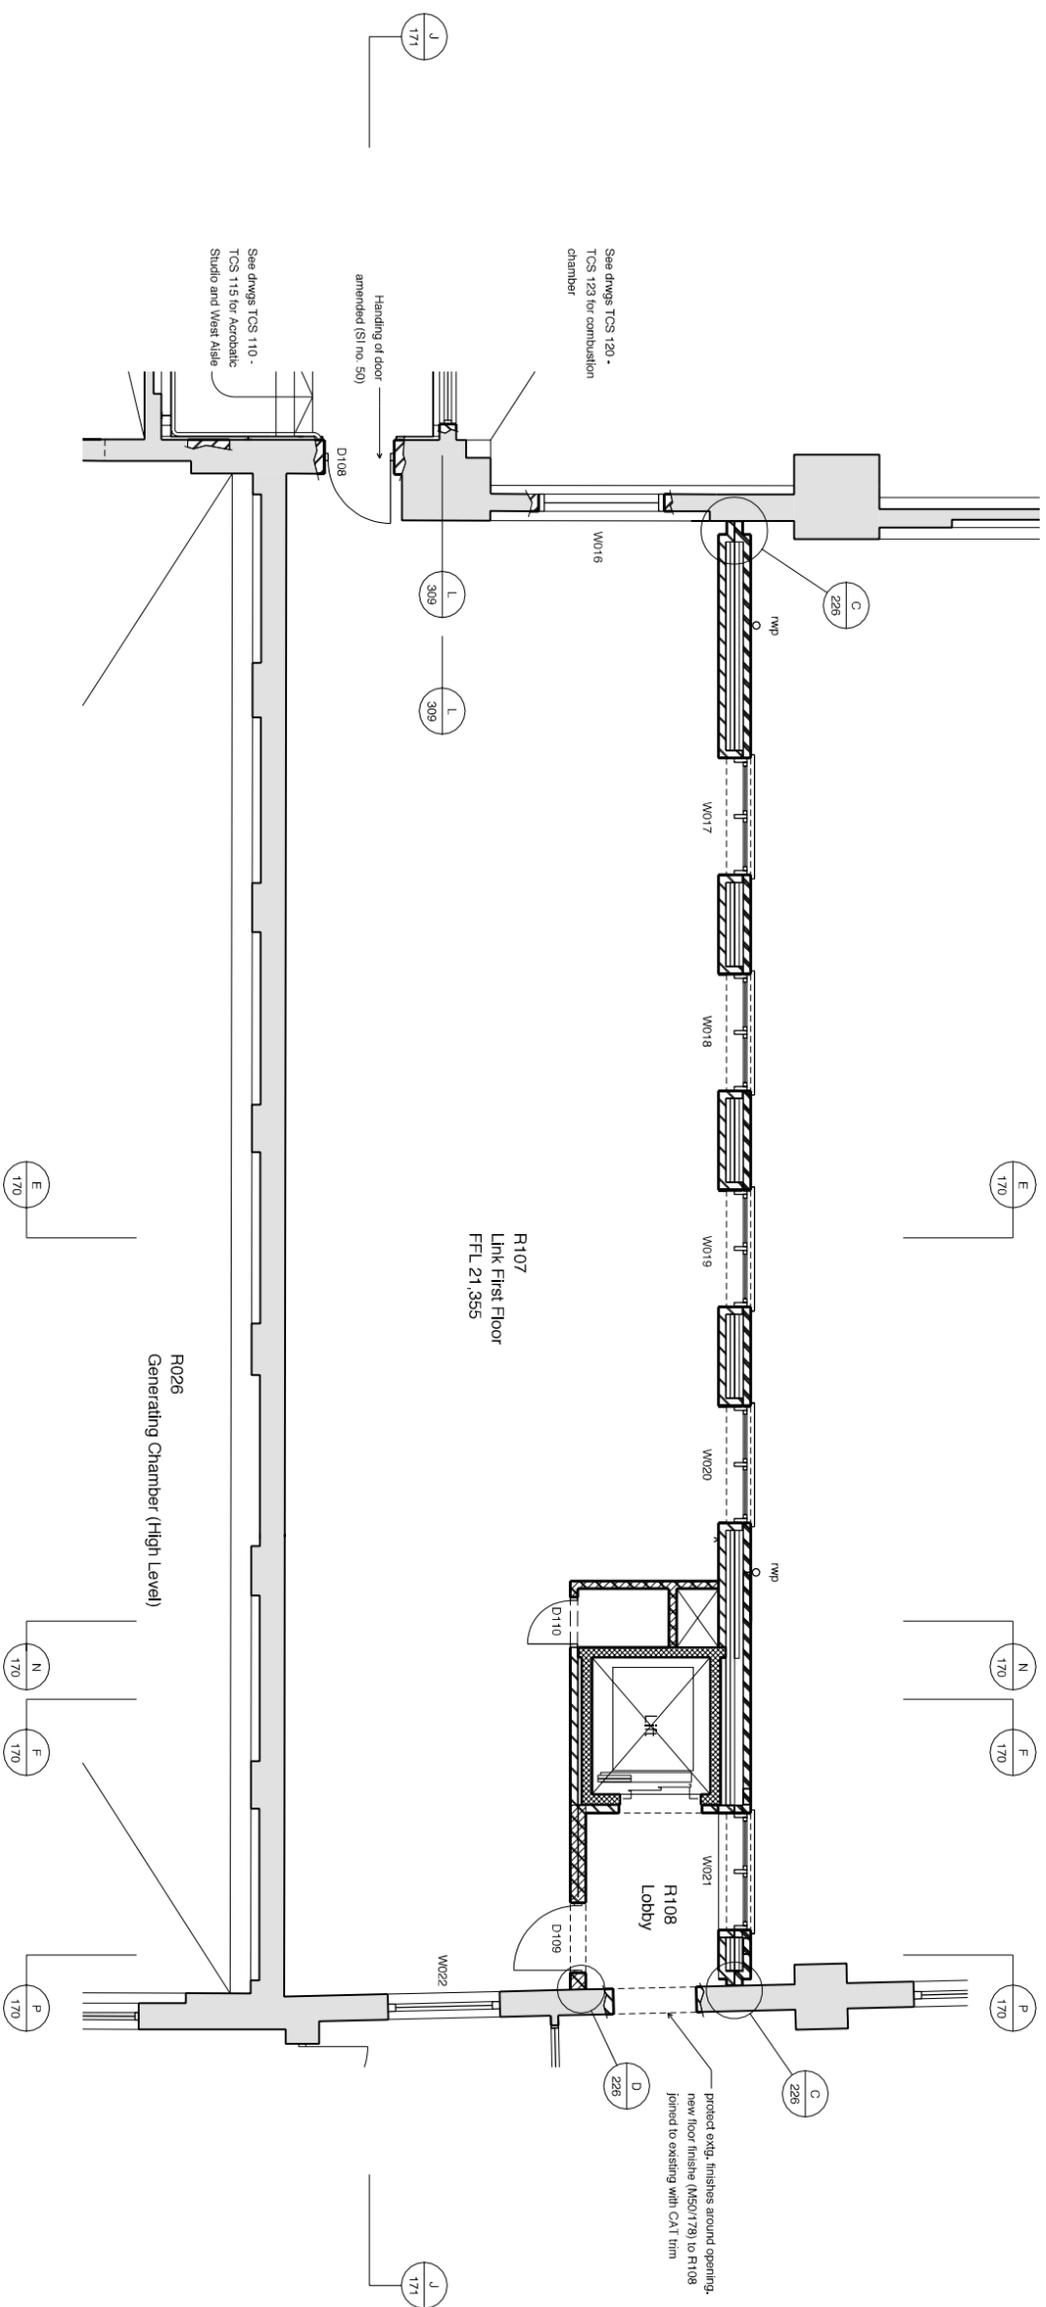

REV.	DATE	NOTES
A	13.10.08	Issued for tender
B	13.01.09	Issued for construction
C	18.12.09	As built - handling of R108 (SI no. 89) indicated

AS BUILT

TIM RONALDS ARCHITECTS

4 Nile Street, London N1 7RF
Telephone 020-7490 7704 Fax 020-7490 1250

THE CIRCUS SPACE
PHASE THREE

LINK
FIRST FLOOR PLAN

SCALE	DRAWN	CHECKED
1:50&A1 1:100&A3	FL	

TCS 131 C